


Rev/No	Revision	Date	Signature	Checked
0	FOR APPROVAL	13-07-2015	KD	

GENERAL NOTES:
 1. DO NOT SCALE THIS DRAWING (DIMENSION SHOULD BE CALCULATED NOT SCALED)
 2. ALL DIMENSIONS ARE IN MILLIMETRES UNLESS INDICATED OTHERWISE. ALL DIMENSIONS TO BE VERIFIED ON SITE & APPROVED BY THE ENGINEER.
 3. THE SITE ENGINEER/SUPERVISOR IS TO NOTIFY THE ARCHITECT/ENGINEER IN WRITING OF ANY DISCREPANCIES IMMEDIATELY AND OBTAIN NECESSARY CLARIFICATION.
 4. THE NOTES ON THIS SHEET ARE TO BE USED ON ALL ARCHITECTURAL DRAWING.
 5. ALL DRAWINGS IN THIS FILE ARE TO BE READ IN CONJUNCTION WITH EACH OTHER (i.e. ARCHITECTURAL, STRUCTURAL, ELECTRICAL, MECHANICAL, INTERIORS, TRANSPORTATION, LANDSCAPING & E. DRAWINGS ALONG WITH THE SPECIFICATIONS & B.O.C.)

NOTES:
 FOR ALL WINDOWS IN MASONRY/CONCRETE ALLOW FOR 15MM PLASTER AT THE SIDES & LINTEL OF WINDOWS OPENINGS

DOCUMENT REVIEW STATUS	
<input type="checkbox"/>	STATUS A: APPROVED FOR CONSTRUCTION.
<input type="checkbox"/>	STATUS B: APPROVED WITH COMMENTS. WORK MAY PROCEED SUBJECT TO INCORPORATION OF COMMENTS INDICATED.
<input type="checkbox"/>	STATUS C: REVISE & RESUBMIT. WORK MAY NOT PROCEED.
<input type="checkbox"/>	STATUS D: REVIEW NOT REQUIRED.

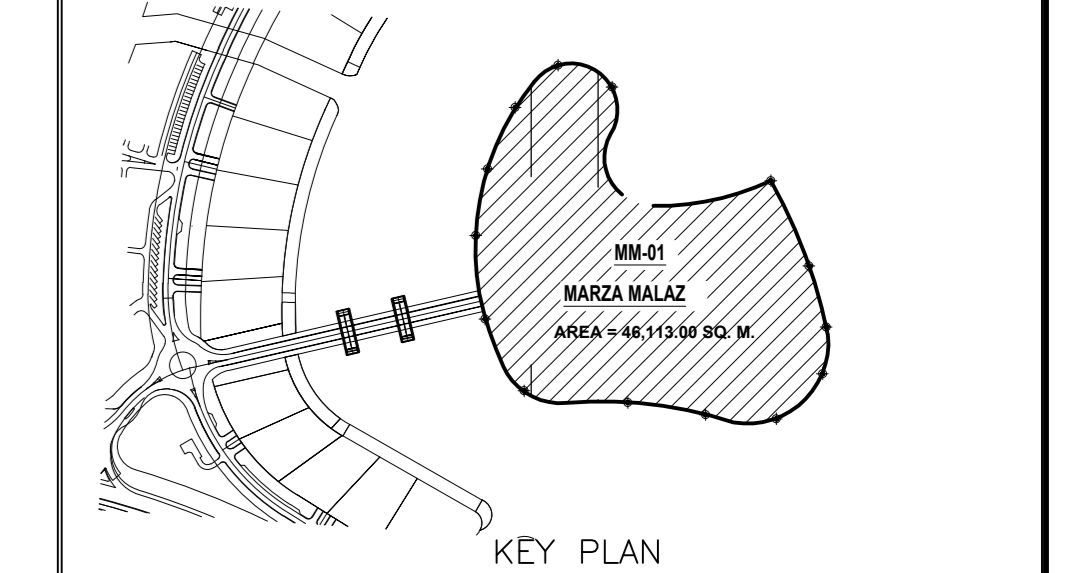

AS BUILT

PROJECT: PROPOSED MARSALA MALAZ HOTEL (B+LG+M+G+5F)
 SITE: THE PEARL QATAR
 CLIENT: AL FARDAN HOSPITALITY

CONSULTANT: **AEB** المشرفون للمهندسين
 AEB HEADQUARTERS: P.O. Box 1748 Doha, Qatar Tel: +974 4458 8888 Fax: +974 4447 7968
 Email: info@aeb-qatar.com Web: www.aeb-qatar.com
 OTHER BRANCHES: ABU DHABI, MANILA, KUALA LUMPUR, MUSCAT

CONTRACTOR: **CONSTRUCTION DEVELOPMENT COMPANY (CDC)**
 P.O. Box 8388
 Doha - Qatar
 TEL: +974 3444 4444
 FAX: +974 3444 3555

1 OVERALL SITE PLAN
 AB A 02 002 SCALE: 1 : 500

TITLE: OVERALL SITE PLAN				
JOB NO.: P-352	DRAWN BY: SN	CHECKED BY: KD	APPROVED BY: WJS	
DATE: 13-07-2015	SCALE: AS SHOWN	DRAWING NO.: MALA.02.002	REVISION: 0	